



Xrefinfo v3.0 Tema Informations teknik
_RD-FL: M:_UPPDRAG\060\026300_Bergsz_62_Arbeitsmaterial\Ritningar\Modell\A-40\1-01.dwg * Elisabeth Isaksson-Norman * 2010-05-04 14:17:31
M:_UPPDRAG\060\026300_Bergsz_62_Arbeitsmaterial\Ritningar\Modell\A-40\1-BL01.dwg 2009-08-03 15:59:33 TM\UPPDRAG\060\026300_Bergsz_62_Arbeitsmaterial\Ritningar\Modell\A-B40\1-01.dwg 2009-04-29 15:42:03 *
Tema arkitekt

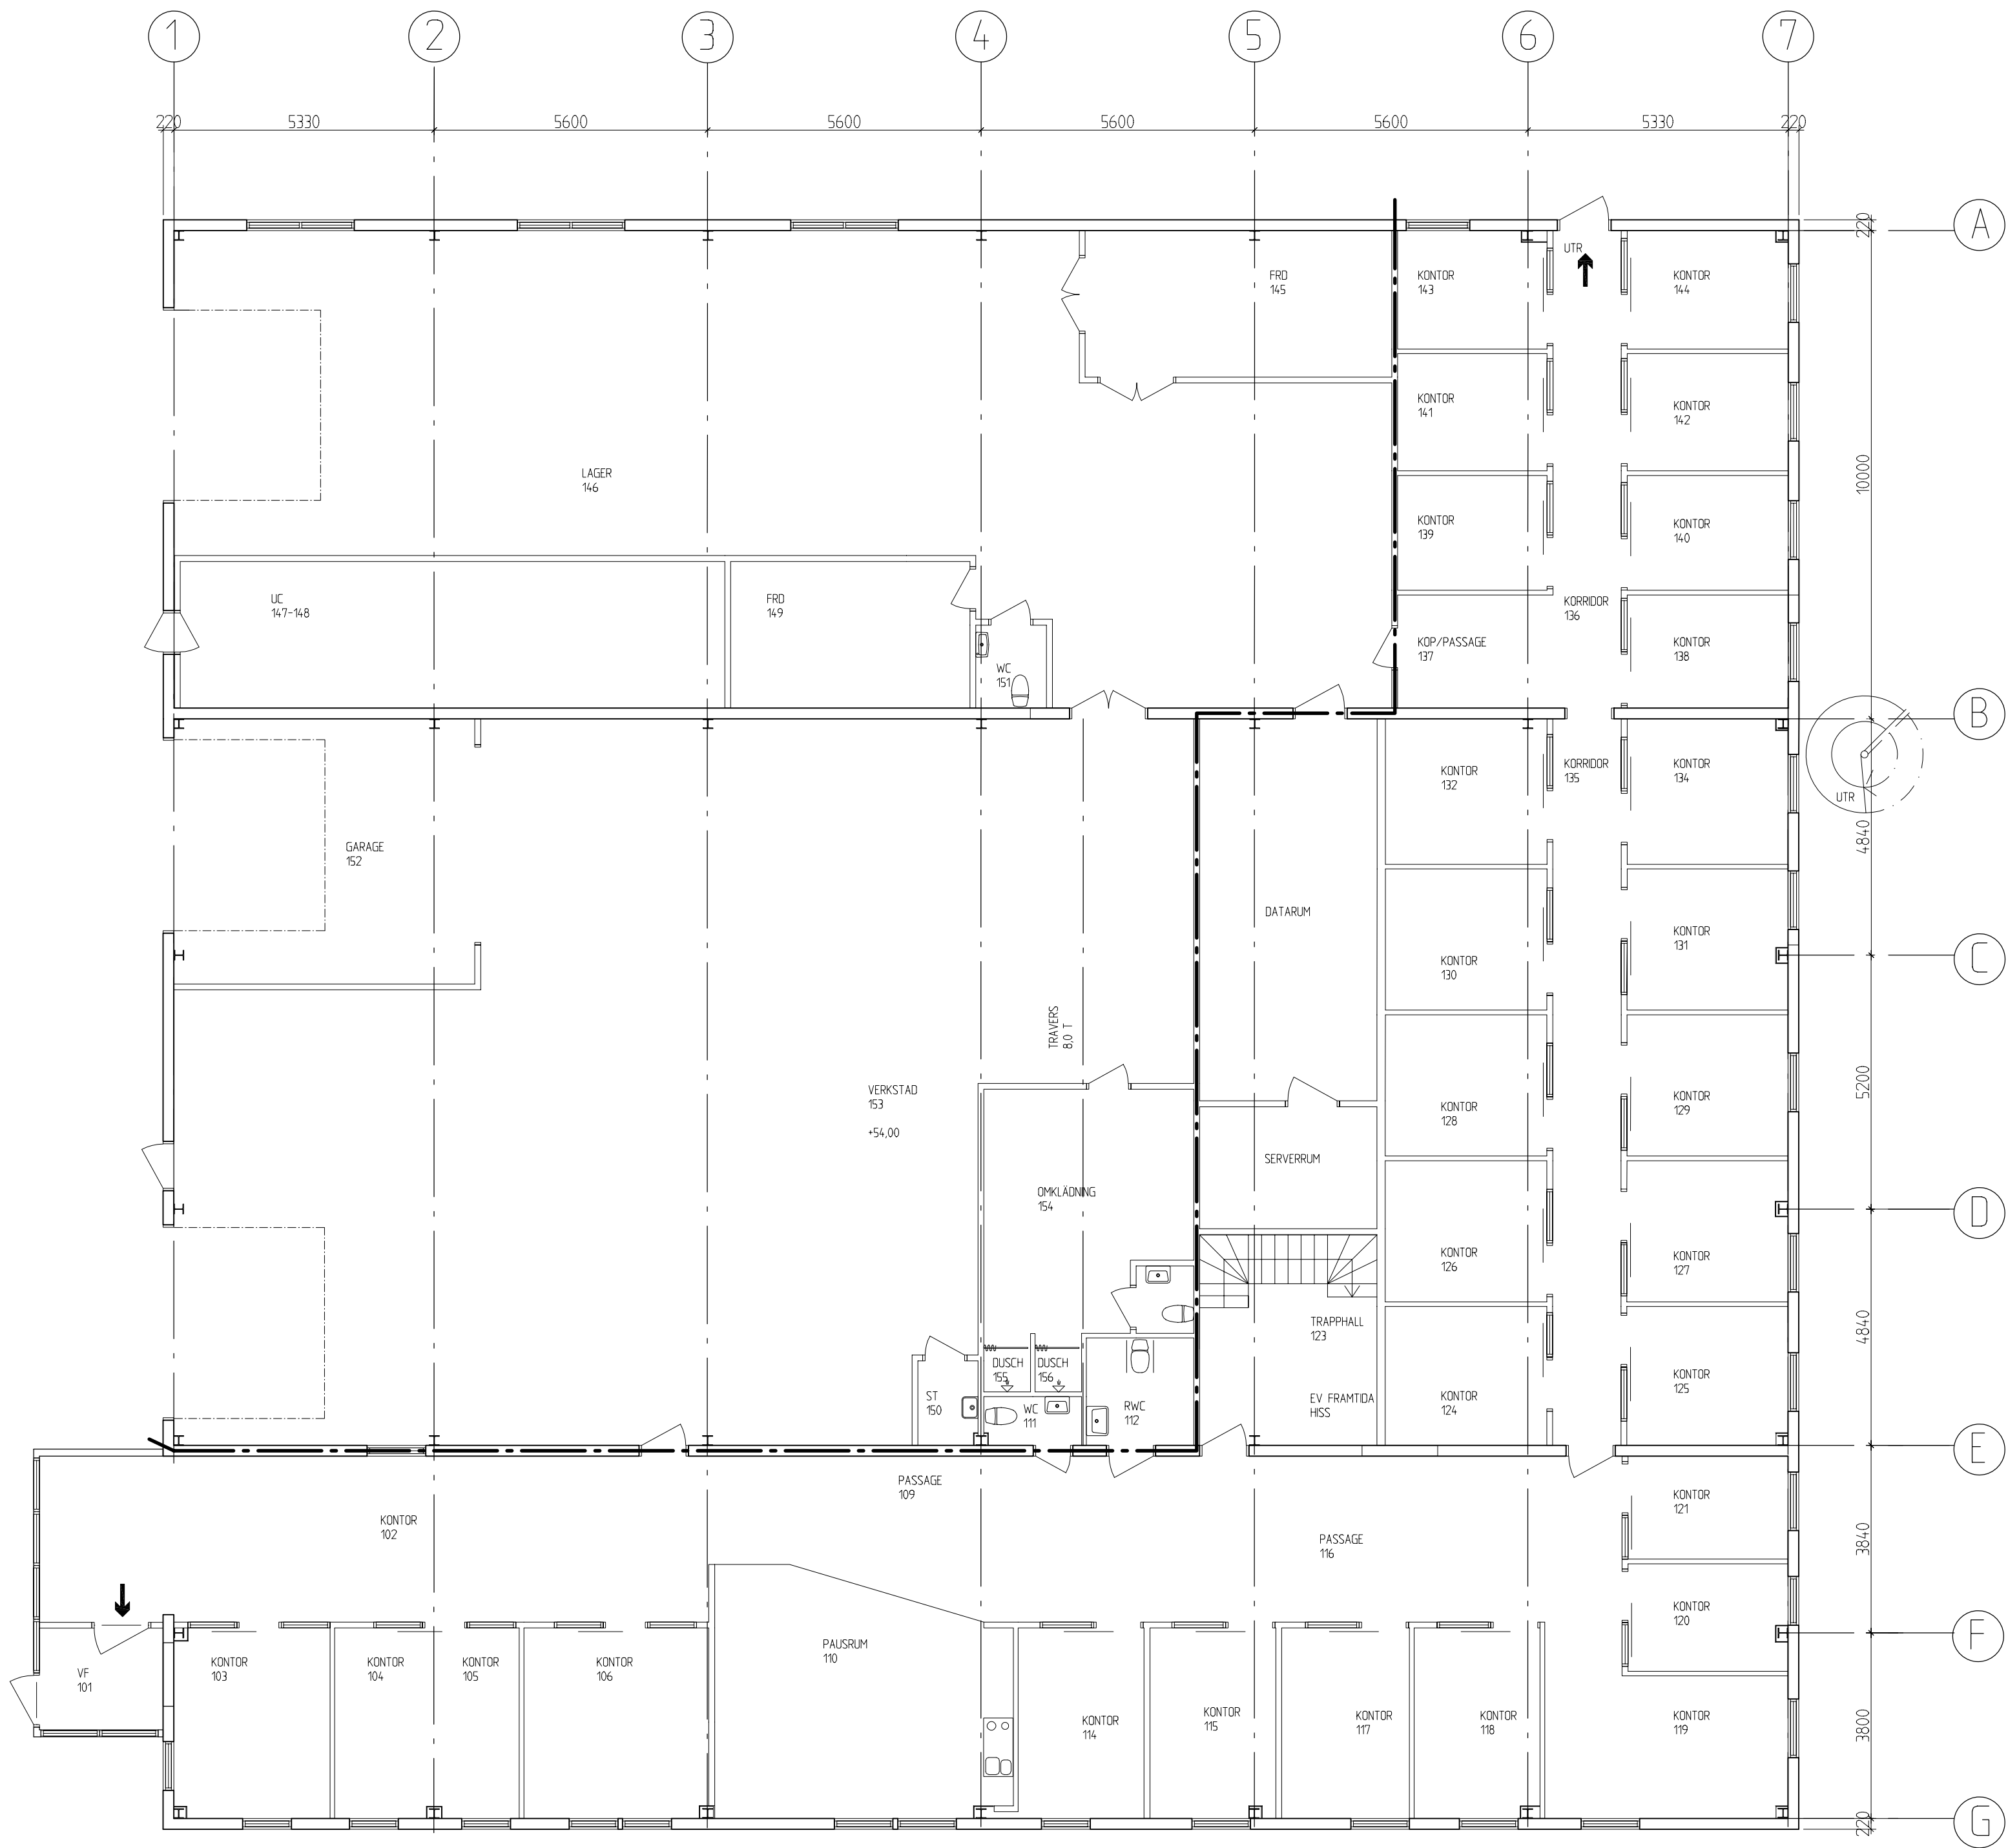

PLAN BV

SKALA 1:100 (A1) 0 2 5 10 m
1:200 (A3)

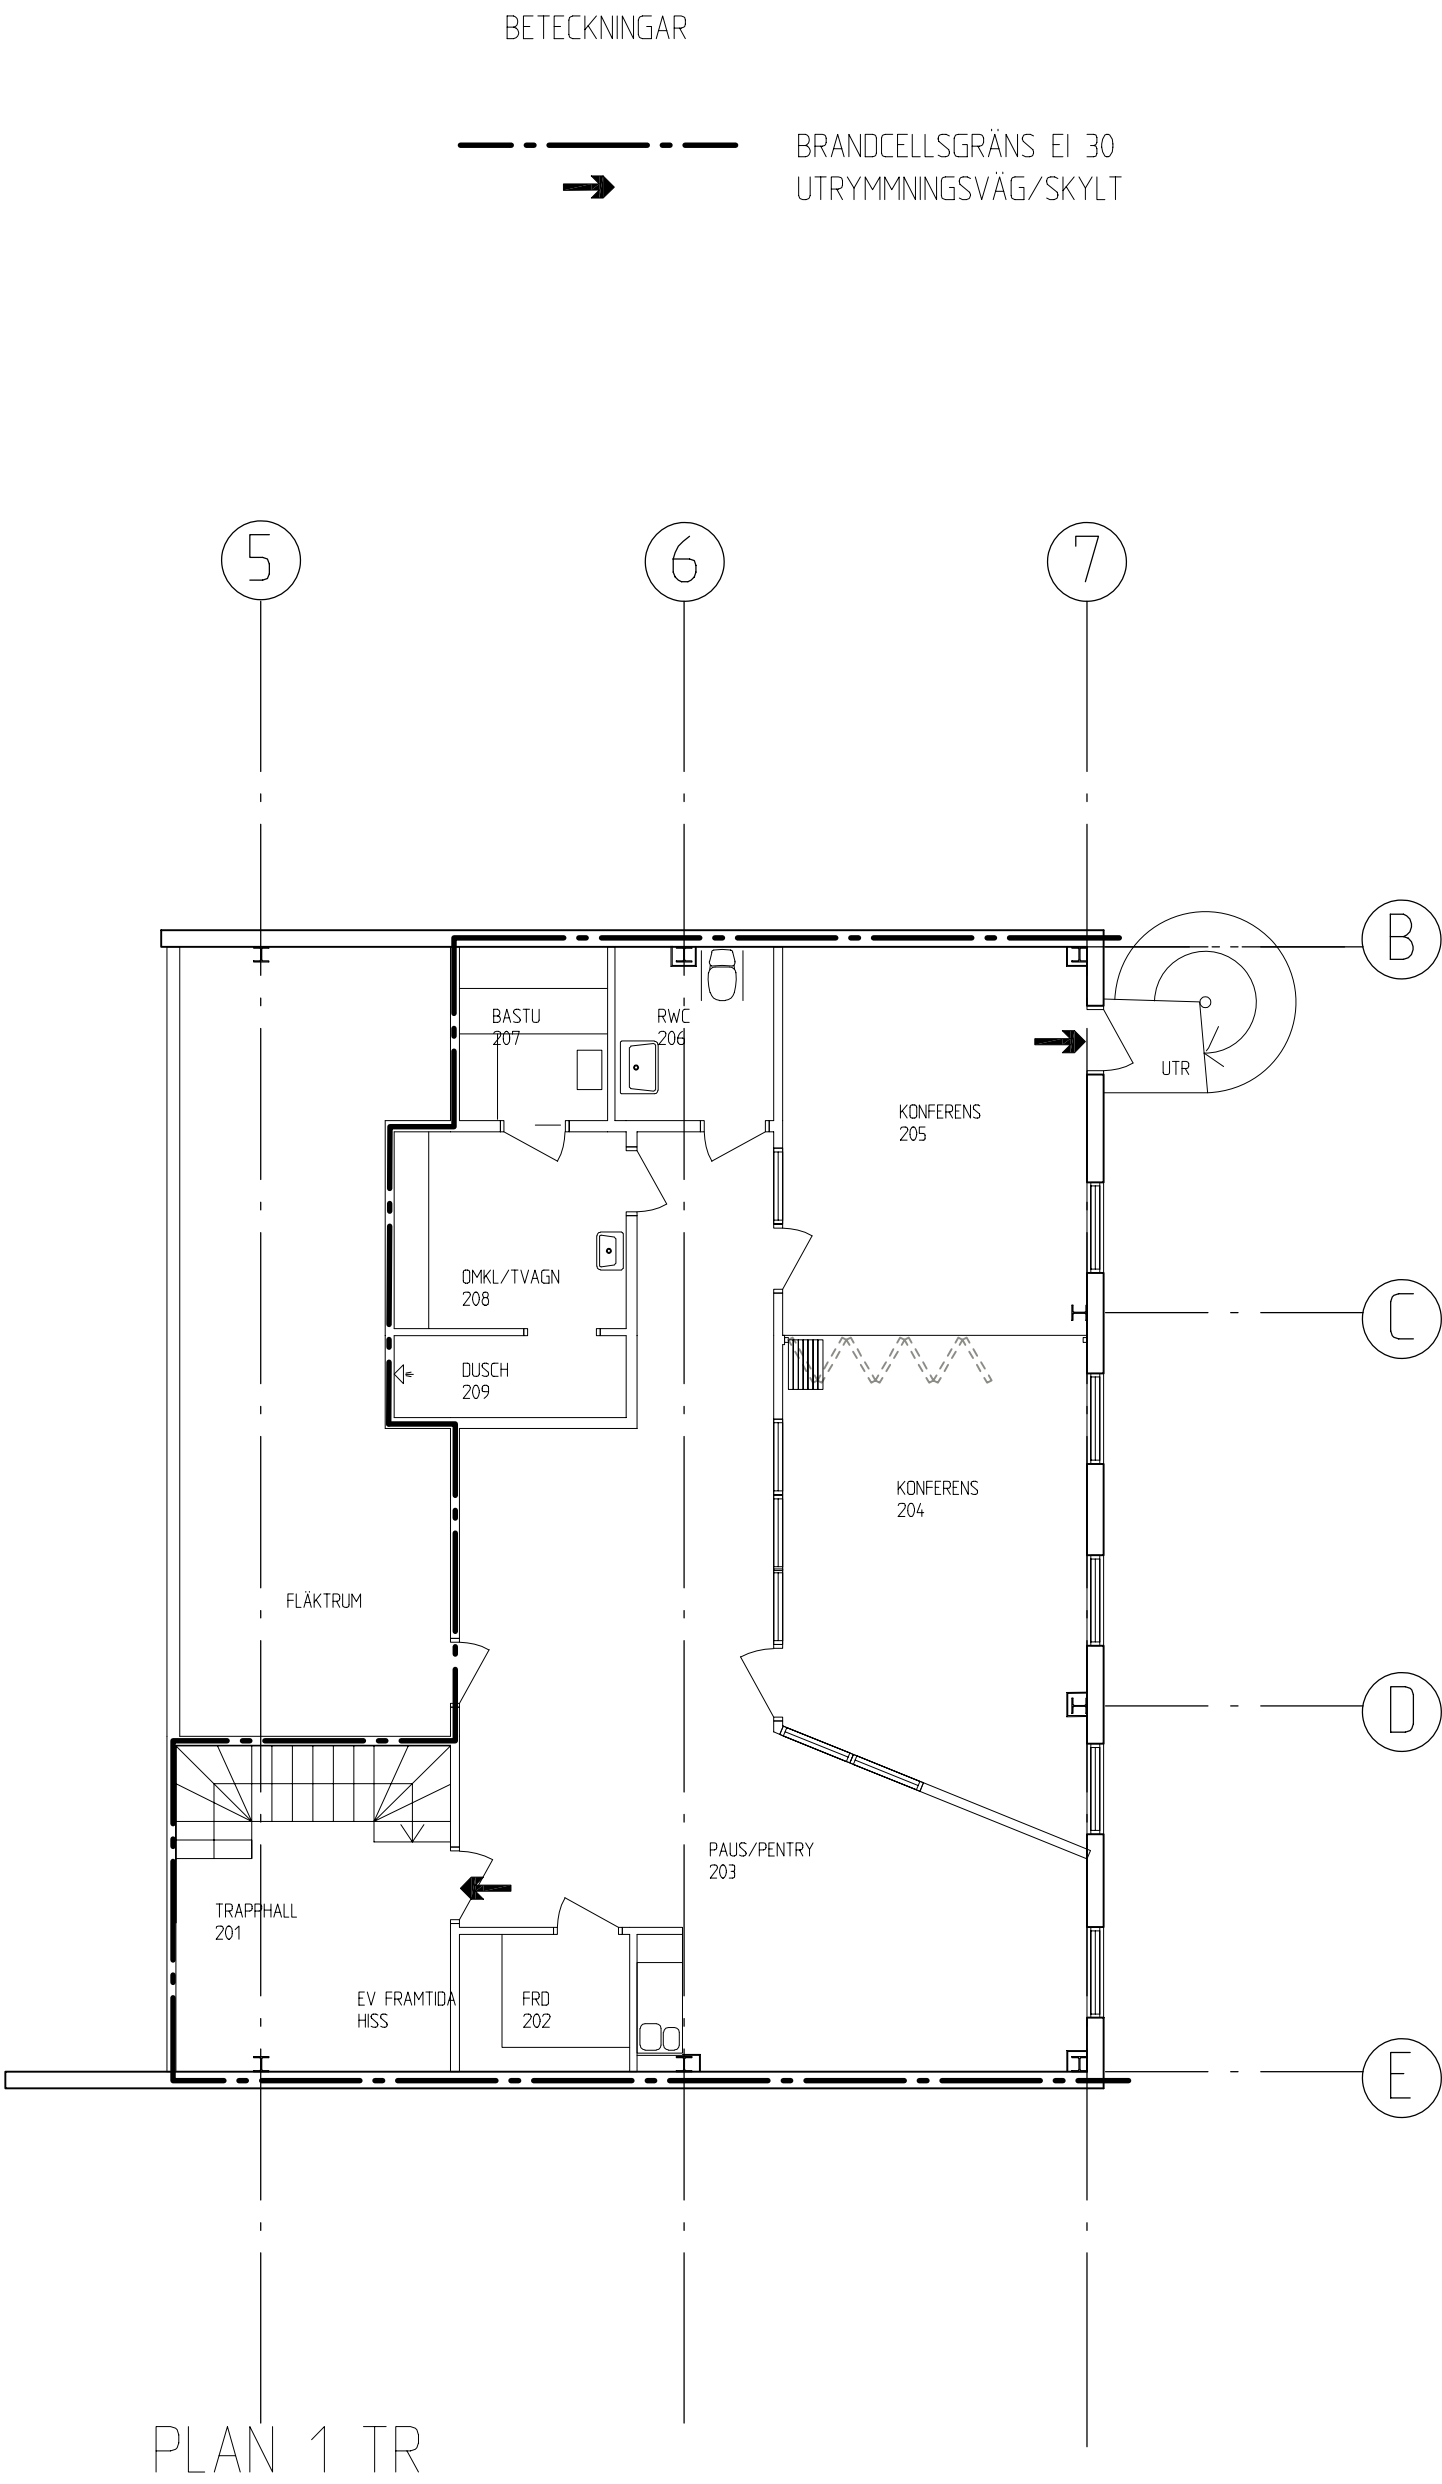

PLAN 1 TR

BET	ANT	ÄNDRING	AVSER	DATUM	SGN
RELATIONSHANDLING					
immobilia Fastigheter					
BERGE 2:6 SKÖN, SUNDSVALL					
tema: ARKITEKTER					
UPPDRAG NR 060026300 DATUM 2010-05-04					
RITAD/KONSTR AV EIN ANSVARIG HAK					
HANDLÄGGARE HAK					
PLANER					
SKALA HJULSKALA 1:100 / HALVSKALA 1:200					
NUMMER A-40.1-01					
BET					